



CR 343(6)

14<sup>th</sup> NORTH

UTILITIES, CROSS SECTIONS

82 0020

1975

# Weatherproof Field Book

"Rite in the Rain" paper  
32 pages

4 $\frac{5}{8}$ " x 7 $\frac{1}{4}$ "

Keuffel & Esser Co., Morristown, N.J. 07960 Made in U.S.A.

### CURVE FORMULAS

$$T = R \tan \frac{1}{2} I$$

$$T = \frac{50 \tan \frac{1}{2} I}{\sin \frac{1}{2} D}$$

$$\sin \frac{1}{2} D = \frac{50}{R}$$

$$\sin \frac{1}{2} D = \frac{50 \tan \frac{1}{2} I}{T}$$

$$R = T \cot \frac{1}{2} I$$

$$R = \frac{50}{\sin \frac{1}{2} D}$$

$$\text{Chord def.} = \frac{\text{chord}^2}{R}$$

$$E = R \operatorname{ex. sec} \frac{1}{2} I$$

$$\text{No. chords} = \frac{I}{D}$$

$$E = T \tan \frac{1}{2} I$$

$$\text{Tan. def.} = \frac{1}{2} \text{ chord def.}$$

The square of any distance, divided by twice the radius, will equal the distance from tangent to curve, very nearly.

To find angle for a given distance and deflection.

Rule 1. Multiply the given distance by .01745 (def. for  $1^\circ$  for 1 ft.) and divide given deflection by the product.

Rule 2. Multiply given deflection by 57.3, and divide the product by the given distance.

To find deflection for a given angle and distance. Multiply the angle by .01745, and the product by the distance.

### GENERAL DATA

RIGHT ANGLE TRIANGLES. Square the altitude, divide by twice the base. Add quotient to base for hypotenuse.

Given Base 100, Alt.  $10.10^2 \div 200 = .5$ .  $100 + .5 = 100.5$  hyp.

Given Hyp. 100, Alt.  $25.25^2 \div 200 = 3.125$ .  $100 - 3.125 = 96.875$  = Base.

Error in first example, .002; in last, .045.

To find Tons of Rail in one mile of track; multiply weight per yard by 11, and divide by 7.

LEVELING. The correction for curvature and refraction, in feet and decimals of feet is equal to  $0.574 d^2$ , where  $d$  is the distance in miles. The correction for curvature alone is closely,  $\frac{2}{3}d^2$ . The combined correction is negative.

PROBABLE ERROR. If  $d_1, d_2, d_3$ , etc. are the discrepancies of various results from the mean, and if  $\sum d^2$  = the sum of the squares of these differences and  $n$  = the number of observations, then the probable error of the mean =  $\pm 0.6745 \sqrt{\frac{\sum d^2}{n(n-1)}}$

### MINUTES IN DECIMALS OF A DEGREE

1'	.0167	11'	.1833	21'	.3500	31'	.5167	41'	.6833	51'	.8500
2'	.0333	12'	.2000	22'	.3667	32'	.5333	42'	.7000	52'	.8667
3'	.0500	13'	.2167	23'	.3833	33'	.5500	43'	.7167	53'	.8833
4'	.0667	14'	.2333	24'	.4000	34'	.5667	44'	.7333	54'	.9000
5'	.0833	15'	.2500	25'	.4167	35'	.5833	45'	.7500	55'	.9167
6'	.1000	16'	.2667	26'	.4333	36'	.6000	46'	.7667	56'	.9333
7'	.1167	17'	.2833	27'	.4500	37'	.6167	47'	.7833	57'	.9500
8'	.1333	18'	.3000	28'	.4667	38'	.6333	48'	.8000	58'	.9667
9'	.1500	19'	.3167	29'	.4833	39'	.6500	49'	.8167	59'	.9833
10'	.1667	20'	.3333	30'	.5000	40'	.6667	50'	.8333	60'	1.0000

### INCHES IN DECIMALS OF A FOOT

1-16	8-32	$\frac{1}{16}$	3-16	$\frac{1}{4}$	5-16	$\frac{3}{16}$	$\frac{1}{2}$	$\frac{5}{16}$	$\frac{3}{8}$	$\frac{7}{16}$
.0052	.0078	.0104	.0156	.0208	.0260	.0313	.0417	.0521	.0625	.0729
1	2	3	4	5	6	7	8	9	10	11
.0833	.1333	.2500	.3333	.4167	.5000	.5833	.6667	.7500	.8333	.9167

### MANHOLE ADJUSTMENT.

24

OBSOLETE SEE P 11 1

$\alpha = 90^\circ 19' 05''$  (FROM ORIGINAL POINT)

10<sup>th</sup> WEST

2710.95

231+00

2681.85

6<sup>th</sup> WEST

10<sup>th</sup> WEST

$\beta = 90^\circ 18' 30''$

231+00

A

B

C

D

E

F

G

H

I

J

K


L

M

N


6<sup>th</sup> WEST

+ HI - EL

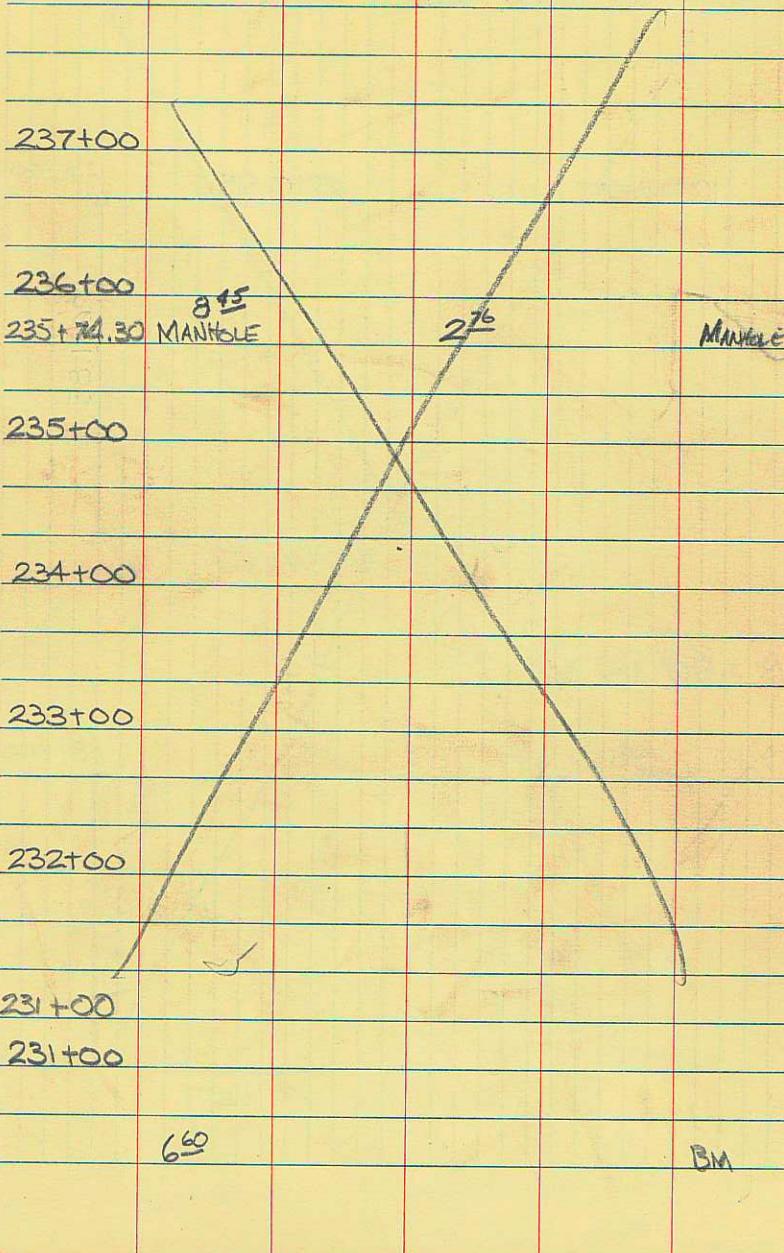

OBSOLETE SEE P. 13-15.

3

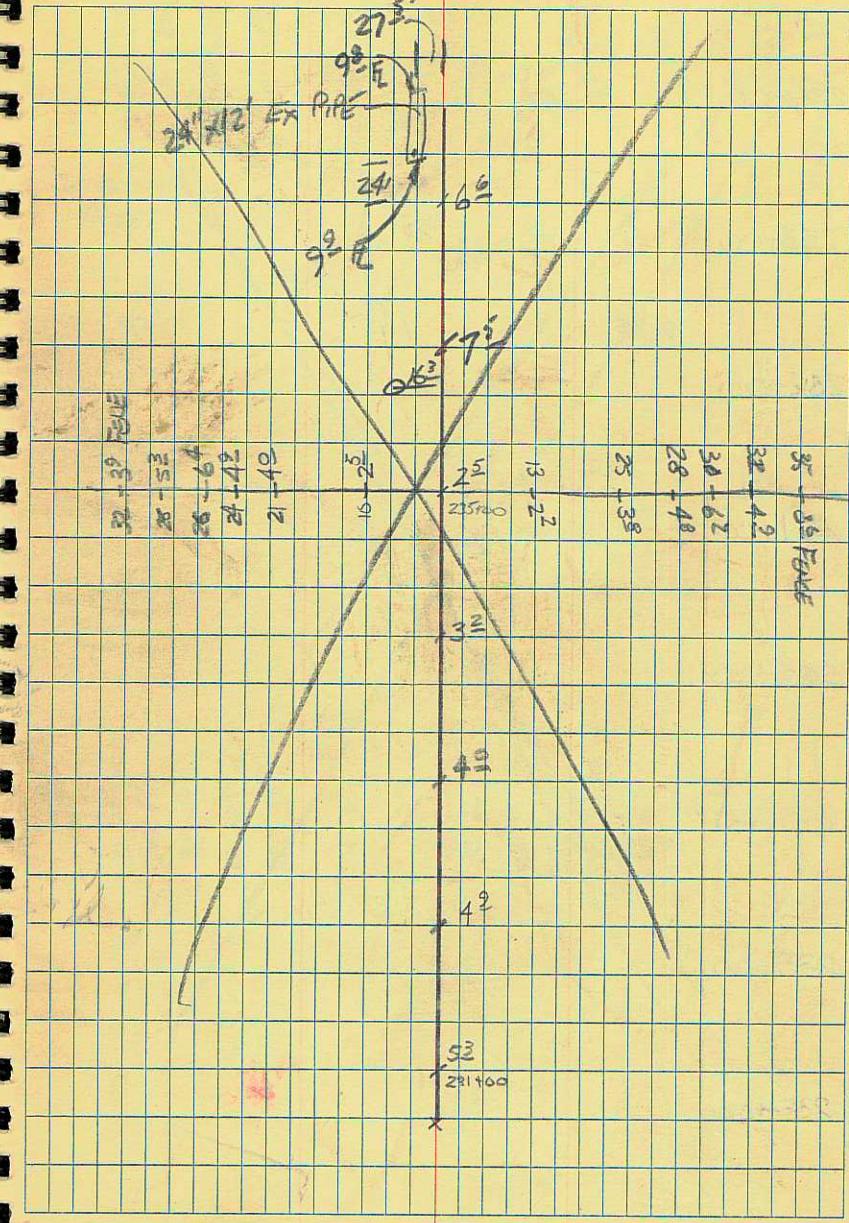

+ HJ - EL

245+00

244+00

8' 82

1' 46

TP

243+00

242+00

241+00

240+00

239+00

238+00

7'-3" Fence

25'-8"

25'-8"

21'-7"

12'-6"

1' 6"

245+00 9' 6"

1' 6"

8' 82

26'-12"

5

Irrigation  
Ditch

Topsoil 9' 6"

GATE

1' 25"

1' 75" 12' 6"

1' 15"

1' 55"

1' 25"

1' 35"

1' 15"

1' 25"

1' 35"

1' 25"

1' 35"

1' 25"

1' 35"

1' 25"

1' 35"

1' 25"

3'-5" Fence

2'-6"

2'-6"

2'-5"

1'-4"

1'-2"

1'-1"

1'-1"

1'-1"

1'-1"

2'-6"

2'-5"

2'-4"

2'-3"

2'-2"

2'-1"

2'-0"

2'-1"

2'-0"

2'-1"

28'-10"

32'-7" + 70' FENCE

28'-12"

26'-9"

28'-8"

12' x 16'

3'-5"

9'-6"

7'

7'-5"

7'

7'-5"

+ HI - EL

253

252

251

7<sup>ft</sup>

215

TP


250



2<sup>ft</sup>  
257+81.85

258+00

257+00

256+00

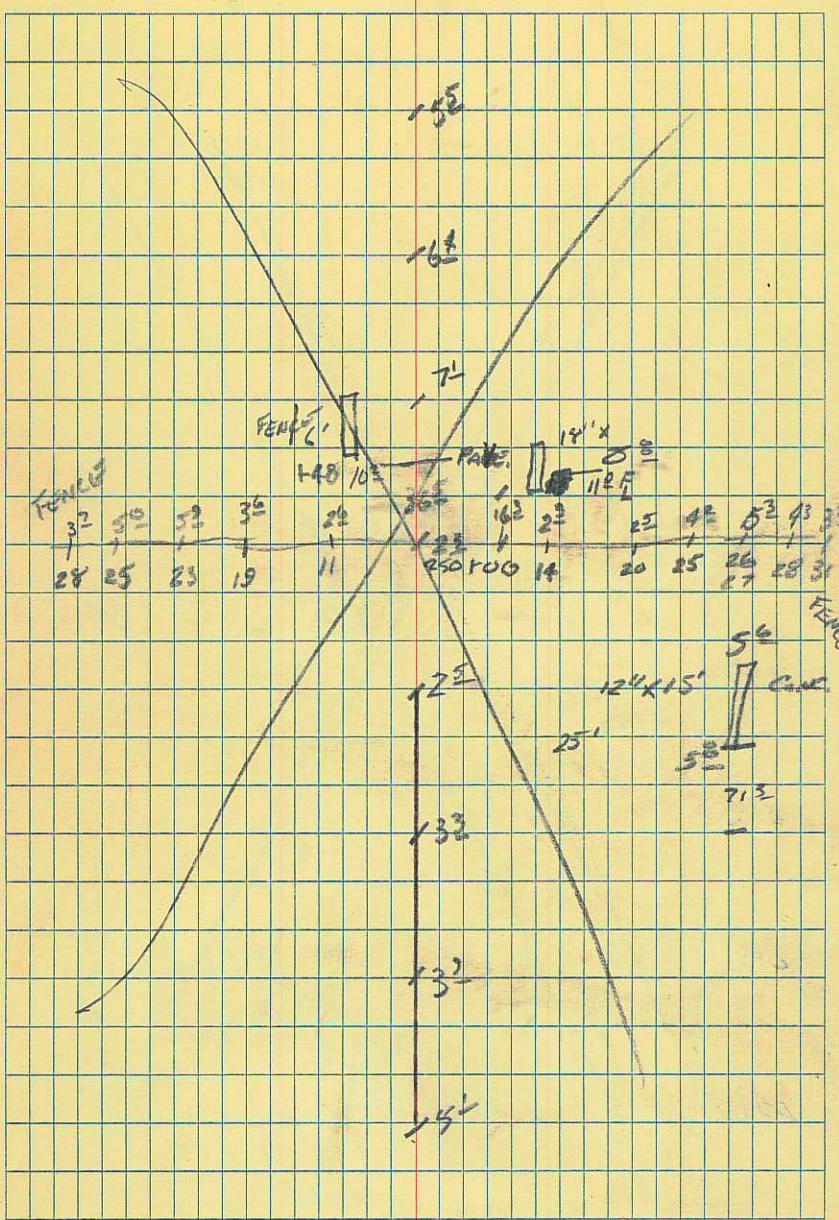

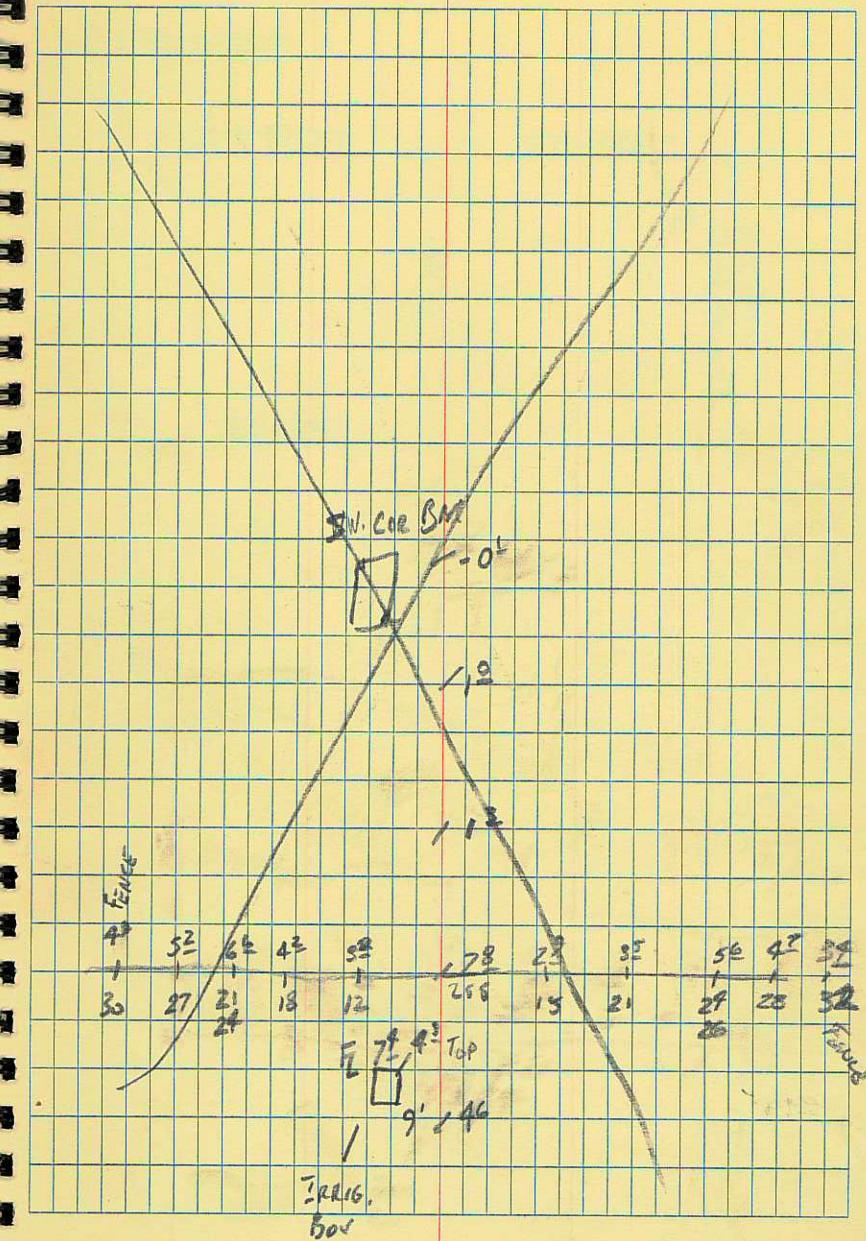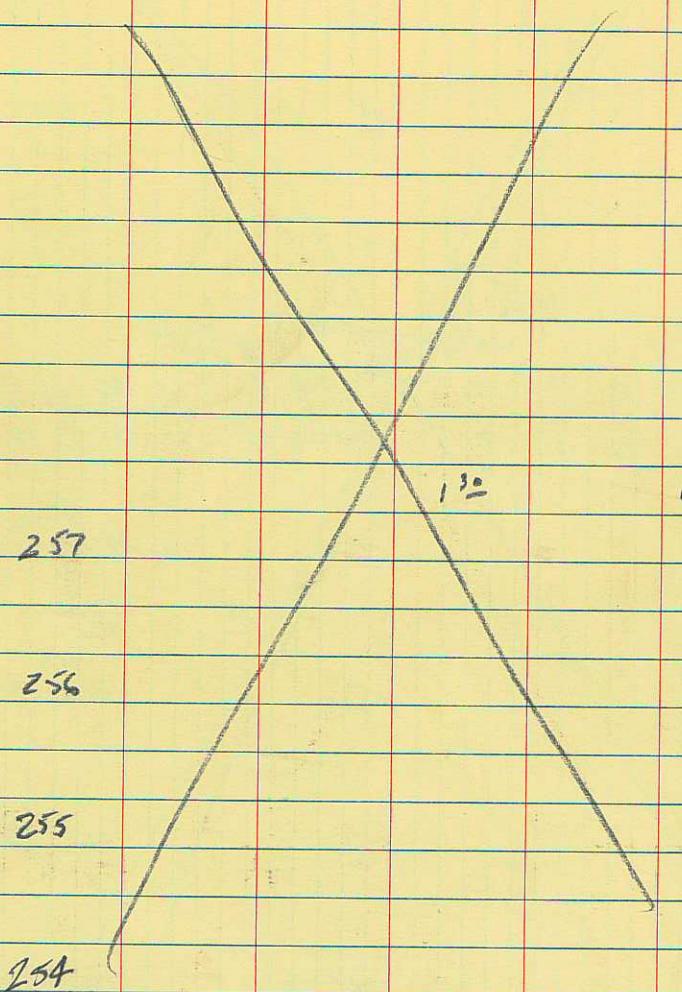

$B = 90^\circ 18' 30''$

10<sup>th</sup> WEST.

2711.43


10<sup>th</sup> No.

6<sup>th</sup> WEST

2681.85  
145 No.

B

	H1	-	EL
236+00		7 <sup>5</sup>	4456 <sup>L</sup>
8 <sup>45</sup>	4463 <sup>61</sup>	2 <sup>76</sup>	4455 <sup>16</sup> MANHOLE BM
235+00		2 <sup>5</sup>	4455 <sup>A</sup>
234+00		3 <sup>2</sup>	4454 <sup>I</sup>
233+00		4 <sup>0</sup>	4453 <sup>Q</sup>
232+00		4 <sup>2</sup>	4453 <sup>Q</sup>
231+00		5 <sup>3</sup>	4452 <sup>S</sup>
6 <sup>60</sup>	4457 <sup>92</sup>		4451 <sup>32</sup> BM

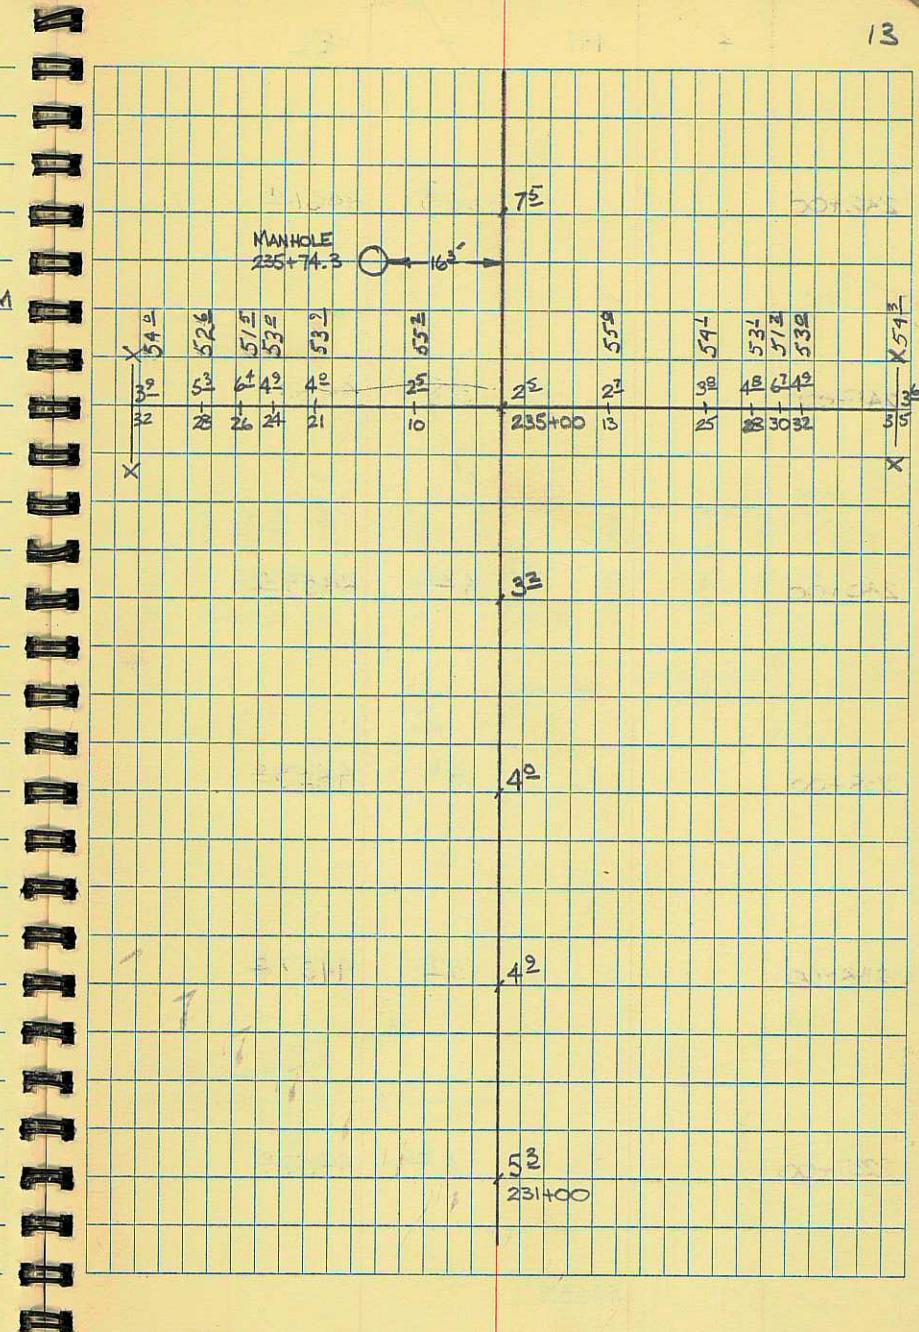

+

HI

-

EL

242+00

2<sup>2</sup>4461<sup>4</sup>

241+00

3<sup>2</sup>4460<sup>4</sup>

240+00

4<sup>2</sup>4459<sup>4</sup>


239+00

4<sup>6</sup>4459<sup>2</sup>

238+00

5<sup>8</sup>4457<sup>8</sup>

237+00

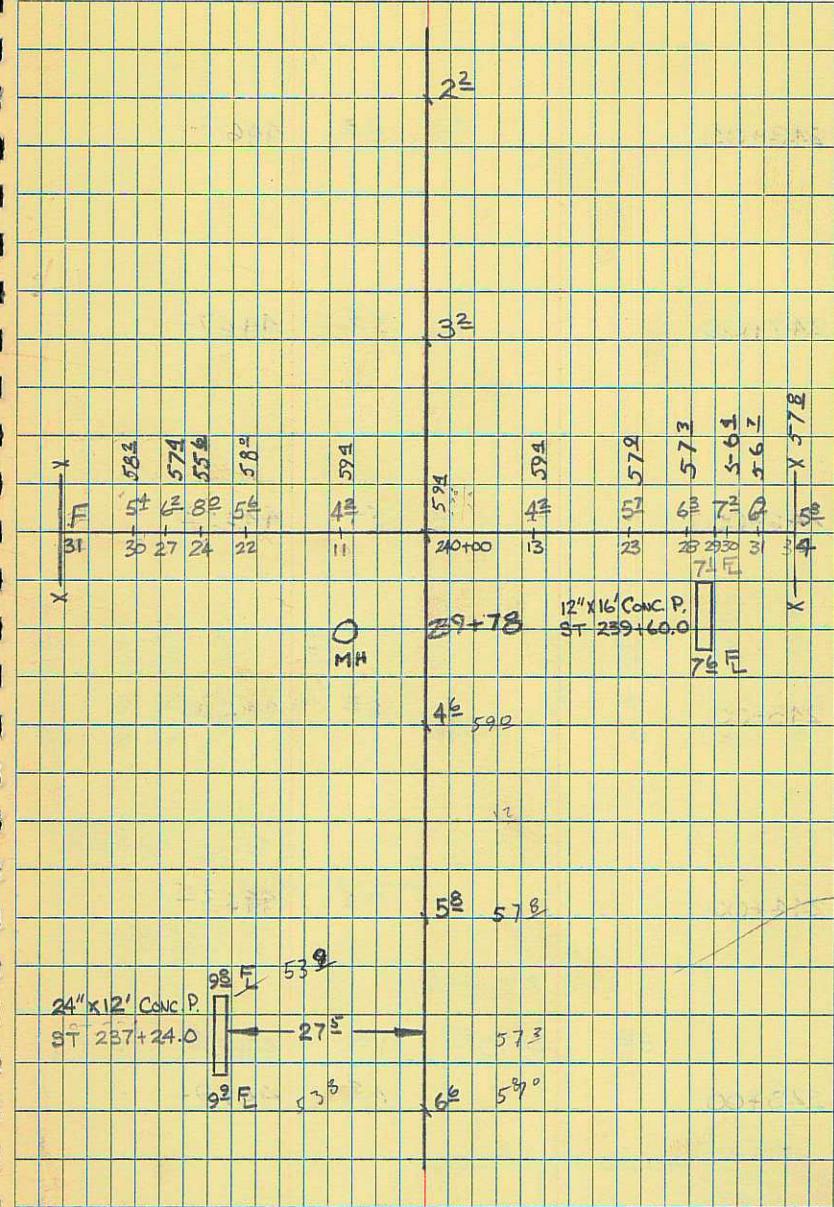6<sup>6</sup>4457<sup>0</sup>4463<sup>6</sup>

+ HI - EL.

248+00

3<sup>3</sup> 4467<sup>2</sup>

247+00

3<sup>2</sup> 4467<sup>1</sup>

246+00

5<sup>1</sup> 4465<sup>2</sup>


245+00

6<sup>3</sup> 4464<sup>8</sup>

244+00

7<sup>5</sup> 4463<sup>5</sup>8<sup>82</sup> 4470<sup>97</sup> 1<sup>46</sup> 4462<sup>15</sup> T.P.

243+00

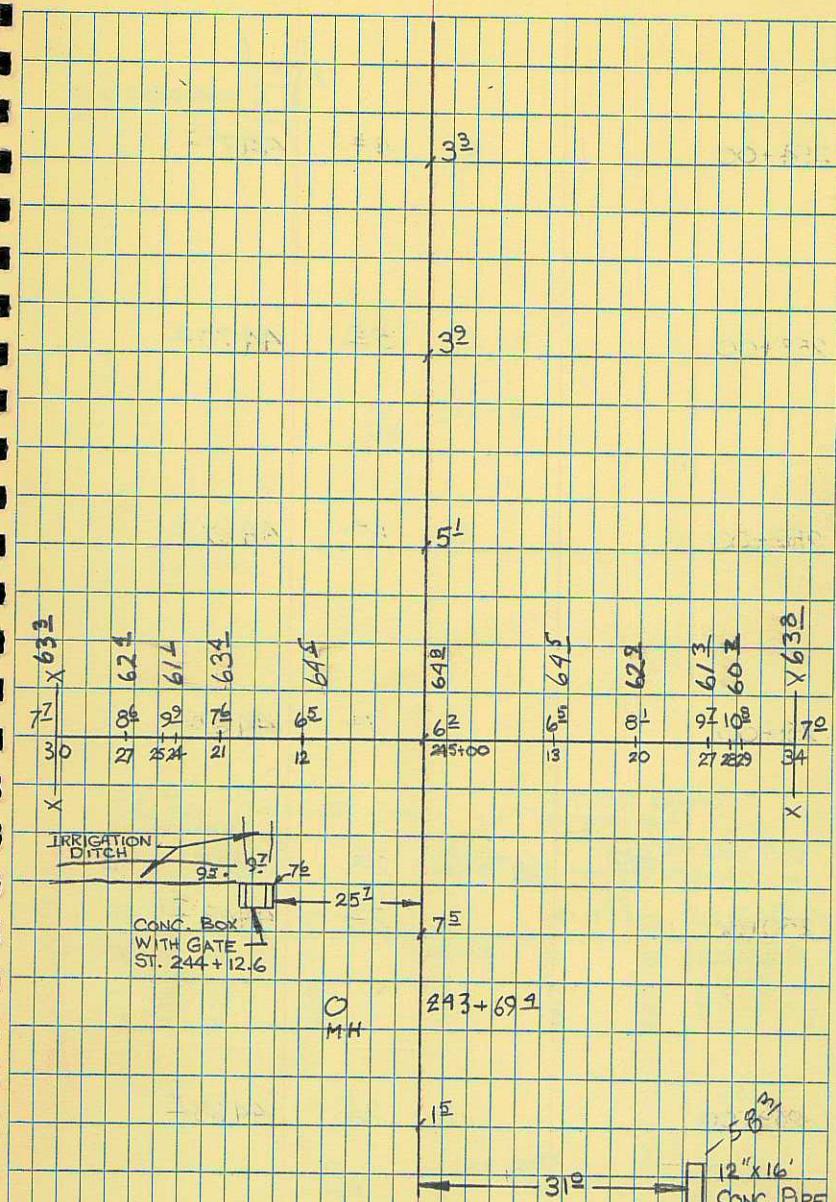1<sup>5</sup> 4462<sup>1</sup>4463<sup>61</sup>

+ HI - EL

254+00

4<sup>6</sup> 4471<sup>2</sup>

253+00

5<sup>5</sup> 4470<sup>8</sup>

252+00

6<sup>4</sup> 4469<sup>2</sup>

251+00

7<sup>1</sup> 4469<sup>2</sup>

7<sup>4</sup> 4476<sup>28</sup>

2<sup>16</sup> 4468<sup>81</sup> T.P.

250+00

2<sup>3</sup> 4468<sup>7</sup>


249+00

2<sup>5</sup> 4468<sup>5</sup>

4470.97

19


CONC. IRRIGATION  
BOX

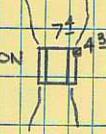

4<sup>6</sup>

5<sup>5</sup>  
O MH 252+81

6<sup>4</sup>

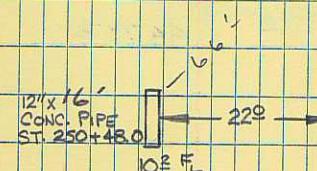

7<sup>1</sup>

PAVEMENT BEGINS  
ST. 250+36<sup>5</sup>  
18'' x 36'' CONC. PIPE  
ST. 250+16.3 X

2 <sup>3</sup>	5 <sup>9</sup>	5 <sup>2</sup>	3 <sup>6</sup>	2 <sup>6</sup>	2 <sup>3</sup>	11 <sup>0</sup>	2 <sup>2</sup>	4 <sup>2</sup>	5 <sup>3</sup>	4 <sup>3</sup>	3 <sup>2</sup>
2.8	25	23	19	11	250+00	14	20	25.2	27.28	31	
X	66 <sup>5</sup>	65 <sup>2</sup>	67 <sup>4</sup>	68 <sup>4</sup>	68 <sup>2</sup>	68 <sup>2</sup>	68 <sup>2</sup>	66 <sup>8</sup>	66 <sup>7</sup>	66 <sup>2</sup>	67 <sup>6</sup>
G73 X											

3<sup>7</sup>  
2.8  
G73 X

5<sup>9</sup>  
25  
66<sup>5</sup>

5<sup>2</sup>  
23  
65<sup>2</sup>

3<sup>6</sup>  
19  
67<sup>4</sup>

2<sup>6</sup>  
11  
68<sup>4</sup>

2<sup>3</sup>  
250+00  
68<sup>2</sup>

2<sup>3</sup>  
14  
68<sup>2</sup>

11<sup>0</sup>  
20  
68<sup>2</sup>

2<sup>2</sup>  
25.2  
68<sup>2</sup>

4<sup>2</sup>  
27.28  
66<sup>8</sup>

5<sup>3</sup>  
31  
66<sup>7</sup>

4<sup>3</sup>  
X  
66<sup>2</sup>

3<sup>2</sup>  
67<sup>6</sup>

O MH

2<sup>5</sup>

5<sup>8</sup> F

12'' x 15'

CONC. PIPE

ST. 248+71<sup>2</sup>

5<sup>8</sup> F

+

HI

-

EL

21

1<sup>30</sup>      4474<sup>98</sup>      BM CONC B.

END PROJECT

257+81.85

257+00

1<sup>0</sup>      4475<sup>3</sup>

256+00

1<sup>3</sup>      4475<sup>2</sup>

255+00

2<sup>8</sup>      4473<sup>5</sup>

4476<sup>28</sup>

/ \ - z

X - X - X      X - X - X  
 PK NAIL → O<sup>2</sup>      6<sup>th</sup> WEST

BM S.W.COR.  
CONC. BOK

1<sup>0</sup>

1<sup>30</sup>

	71 <sup>1</sup>	69 <sup>2</sup>	72 <sup>1</sup>	73 <sup>1</sup>	73 <sup>2</sup>	73 <sup>3</sup>	73 <sup>4</sup>	73 <sup>5</sup>
4 <sup>3</sup>	5 <sup>2</sup>	6 <sup>6</sup>	4 <sup>2</sup>	3 <sup>2</sup>	2 <sup>8</sup>	2 <sup>9</sup>	3 <sup>5</sup>	2 <sup>4</sup>
3 <sup>0</sup>	2 <sup>7</sup>	2 <sup>4</sup> -2 <sup>1</sup>	1 <sup>8</sup>	1 <sup>2</sup>	255+00	21	24-26-28	3 <sup>2</sup>

## MAN HOLE STATIONS &amp; ELEVATIONS

STATION	+	HI	-	ELEV
---------	---	----	---	------

43-75  
COOL (A5°) APPROX.  
VERY WINDY  
T WAED  
P WILLIAMS

-4<sup>64</sup> 69<sup>07</sup> BM

252+81 3.30 70<sup>41</sup> MH5

248+801 6<sup>42</sup> 67<sup>23</sup> MH4  
TP +9.31 73<sup>71</sup> -1<sup>53</sup> 64<sup>40</sup>

243+694 4<sup>01</sup> 61<sup>92</sup> MH3

239+78 7<sup>22</sup> 58<sup>16</sup> MH2  
TP +7<sup>00</sup> 65<sup>93</sup> -0.63 58<sup>23</sup>

235+73 4<sup>41</sup> 55<sup>15</sup> MH1

+8<sup>24</sup> 59<sup>56</sup>

4451<sup>32</sup> BM

385  
392  
777

25

+ HI - EL

8 02 4451 33

BNL Ht<sup>n</sup> No.  
(51 22)

4451 32 BM

TP 1421 No.  
UNIMPROVED  
SECTION

8/11/75

AS BUILT CROSS- 27

WARD  
WILLIAMS  
HOAN &

SECTION AND PIPE  
ELEVATION, TO DETERMINE  
CHANGES IN DITCH E. EL.

235+00 5' 52' 24' 27'  
100' 60' 3' 25' 21'

234+00 6' 7' 28' DITCH  
50' 282

233+00 6' 12' 282  
50' 282


232+00 7' 8' 282  
50' 282

231+00 8' 9' 282  
50' 282  
102' F. INLET  
18" CMP

IN EXISTING DITCH 230+00 102' F. OUTLET

242 + 43.47

## TRIGONOMETRIC FORMULAS

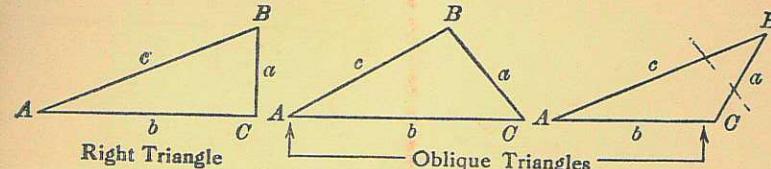

### Solution of Right Triangles

For Angle  $A$ .  $\sin = \frac{a}{c}$ ,  $\cos = \frac{b}{c}$ ,  $\tan = \frac{a}{b}$ ,  $\cot = \frac{b}{a}$ ,  $\sec = \frac{c}{b}$ ,  $\operatorname{cosec} = \frac{c}{a}$

Given $a, b$	Required $A, B, c$	$\tan A = \frac{a}{b} = \cot B$ , $c = \sqrt{a^2 + b^2} = a\sqrt{1 + \frac{b^2}{a^2}}$
-----------------	-----------------------	--

$a, c$	$A, B, b$	$\sin A = \frac{a}{c} = \cos B$ , $b = \sqrt{(c+a)(c-a)} = c\sqrt{1 - \frac{a^2}{c^2}}$
--------	-----------	---

$A, a$	$B, b, c$	$B = 90^\circ - A$ , $b = a \cot A$ , $c = \frac{a}{\sin A}$
--------	-----------	--

$A, b$	$B, a, c$	$B = 90^\circ - A$ , $a = b \tan A$ , $c = \frac{b}{\cos A}$
--------	-----------	--

$A, c$	$B, a, b$	$B = 90^\circ - A$ , $a = c \sin A$ , $b = c \cos A$
--------	-----------	--

### Solution of Oblique Triangles

Given $A, B, a$	Required $b, c, C$	$b = \frac{a \sin B}{\sin A}$ , $C = 180^\circ - (A + B)$ , $c = \frac{a \sin C}{\sin A}$
--------------------	-----------------------	---

$A, a, b$	$B, c, C$	$\sin B = \frac{b \sin A}{a}$ , $C = 180^\circ - (A + B)$ , $c = \frac{a \sin C}{\sin A}$
-----------	-----------	---

$a, b, C$	$A, B, c$	$A + B = 180^\circ - C$ , $\tan \frac{1}{2}(A-B) = \frac{(a-b)\tan \frac{1}{2}(A+B)}{a+b}$ , $c = \frac{a \sin C}{\sin A}$
-----------	-----------	---

$a, b, c$	$A, B, C$	$s = \frac{a+b+c}{2}$ , $\sin \frac{1}{2}A = \sqrt{\frac{(s-b)(s-c)}{bc}}$ , $\sin \frac{1}{2}B = \sqrt{\frac{(s-a)(s-c)}{ac}}$ , $C = 180^\circ - (A+B)$ .
-----------	-----------	--

$a, b, c$	Area	$s = \frac{a+b+c}{2}$ , area = $\sqrt{s(s-a)(s-b)(s-c)}$
-----------	------	--

$A, b, c$	Area	$\text{area} = \frac{b c \sin A}{2}$
-----------	------	--------------------------------------


$A, B, C, a$	Area	$\text{area} = \frac{a^2 \sin B \sin C}{2 \sin A}$
--------------	------	--

### REDUCTION TO HORIZONTAL

Horizontal distance = Slope distance multiplied by the cosine of the vertical angle. Thus: slope distance = 319.4 ft. Vert. angle =  $5^\circ 10'$ . Since  $\cos 5^\circ 10' = .9959$ , horizontal distance =  $319.4 \times .9959 = 318.09$  ft.

Horizontal distance also = Slope distance minus slope distance times (1 - cosine of vertical angle). With the same figures as in the preceding example, the following result is obtained. Cosine  $5^\circ 10' = .9959$ .  $1 - .9959 = .0041$ .  $319.4 \times .0041 = 1.31$ .  $319.4 - 1.31 = 318.09$  ft.

When the rise is known, the horizontal distance is approximately the slope distance less the square of the rise divided by twice the slope distance. Thus: rise = 14 ft., slope distance = 302.6 ft. Horizontal distance =  $302.6 - \frac{14 \times 14}{2 \times 302.6} = 302.6 - 0.32 = 302.28$  ft.

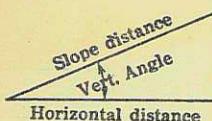

Rise